
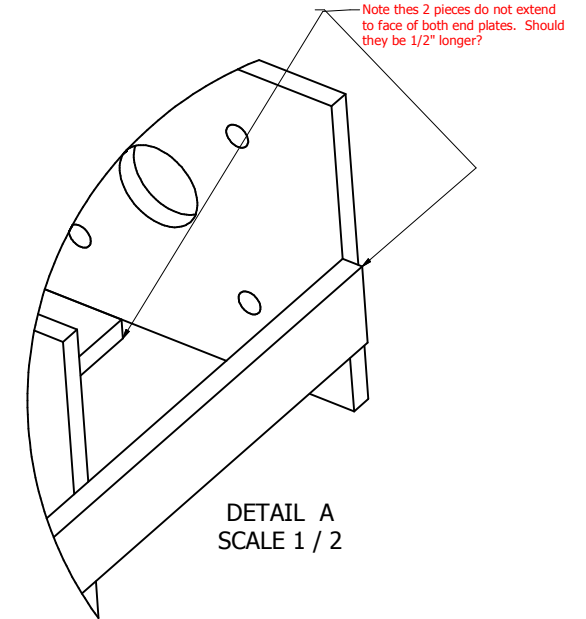
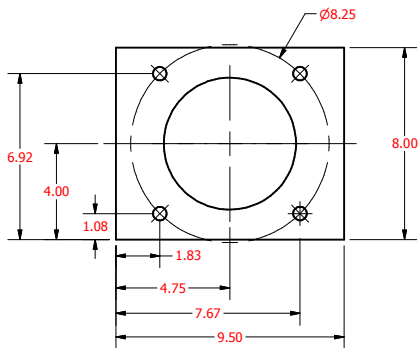
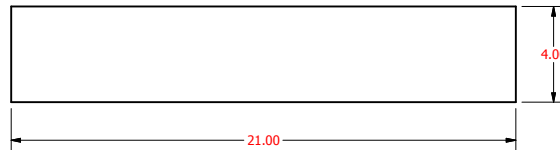
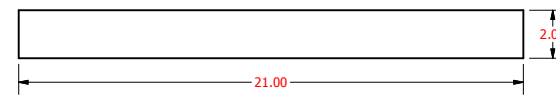
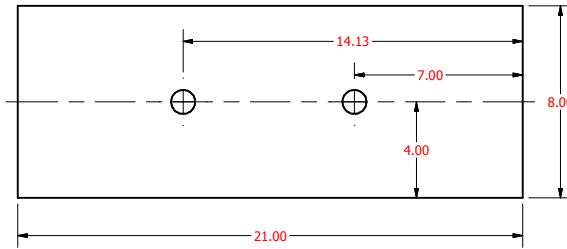
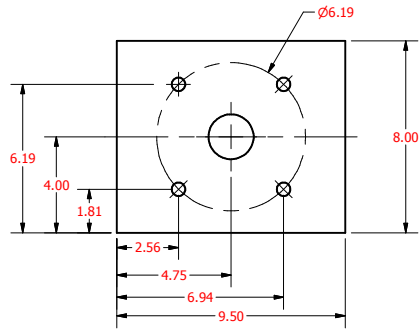
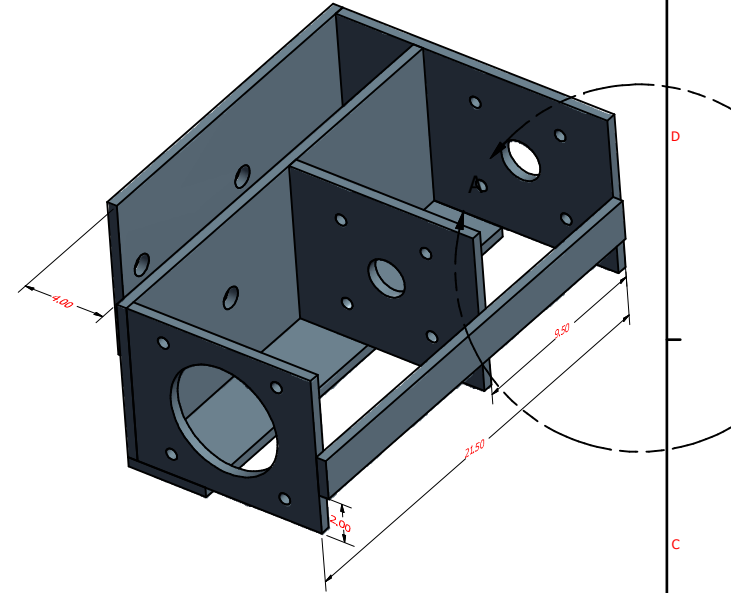
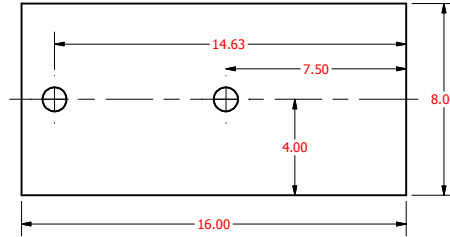


# Frame and Parts for Quick Change Wheel Assembly

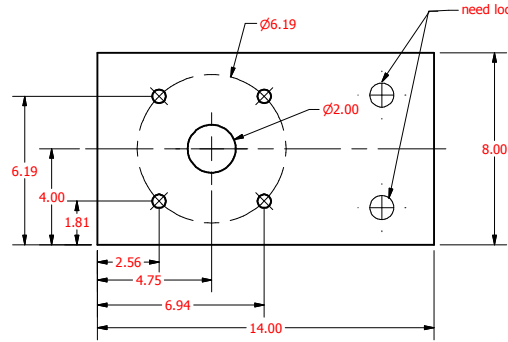

Please label/name each piece by the name you would like to call it.

DRAWN	R W Olson	1/5/2012	TITLE		
CHECKED			TITLE		
QA			TITLE		
MFG			TITLE		
APPROVED			TITLE		
SIZE	C	DWG NO	Wheel Assembly Mounting Frame		REV
SCALE					
				SHEET 1 OF 1	